


Basement & baths


SCALE: 1" = 10'-0"

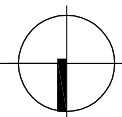

Panama Hotel


As-Built Drawings
April 7th, 2014

Drawn by:
Brian Baker
414 13th Ave E PH1
Seattle, WA 98102
206.931.6452
bmbaker.arch@gmail.com

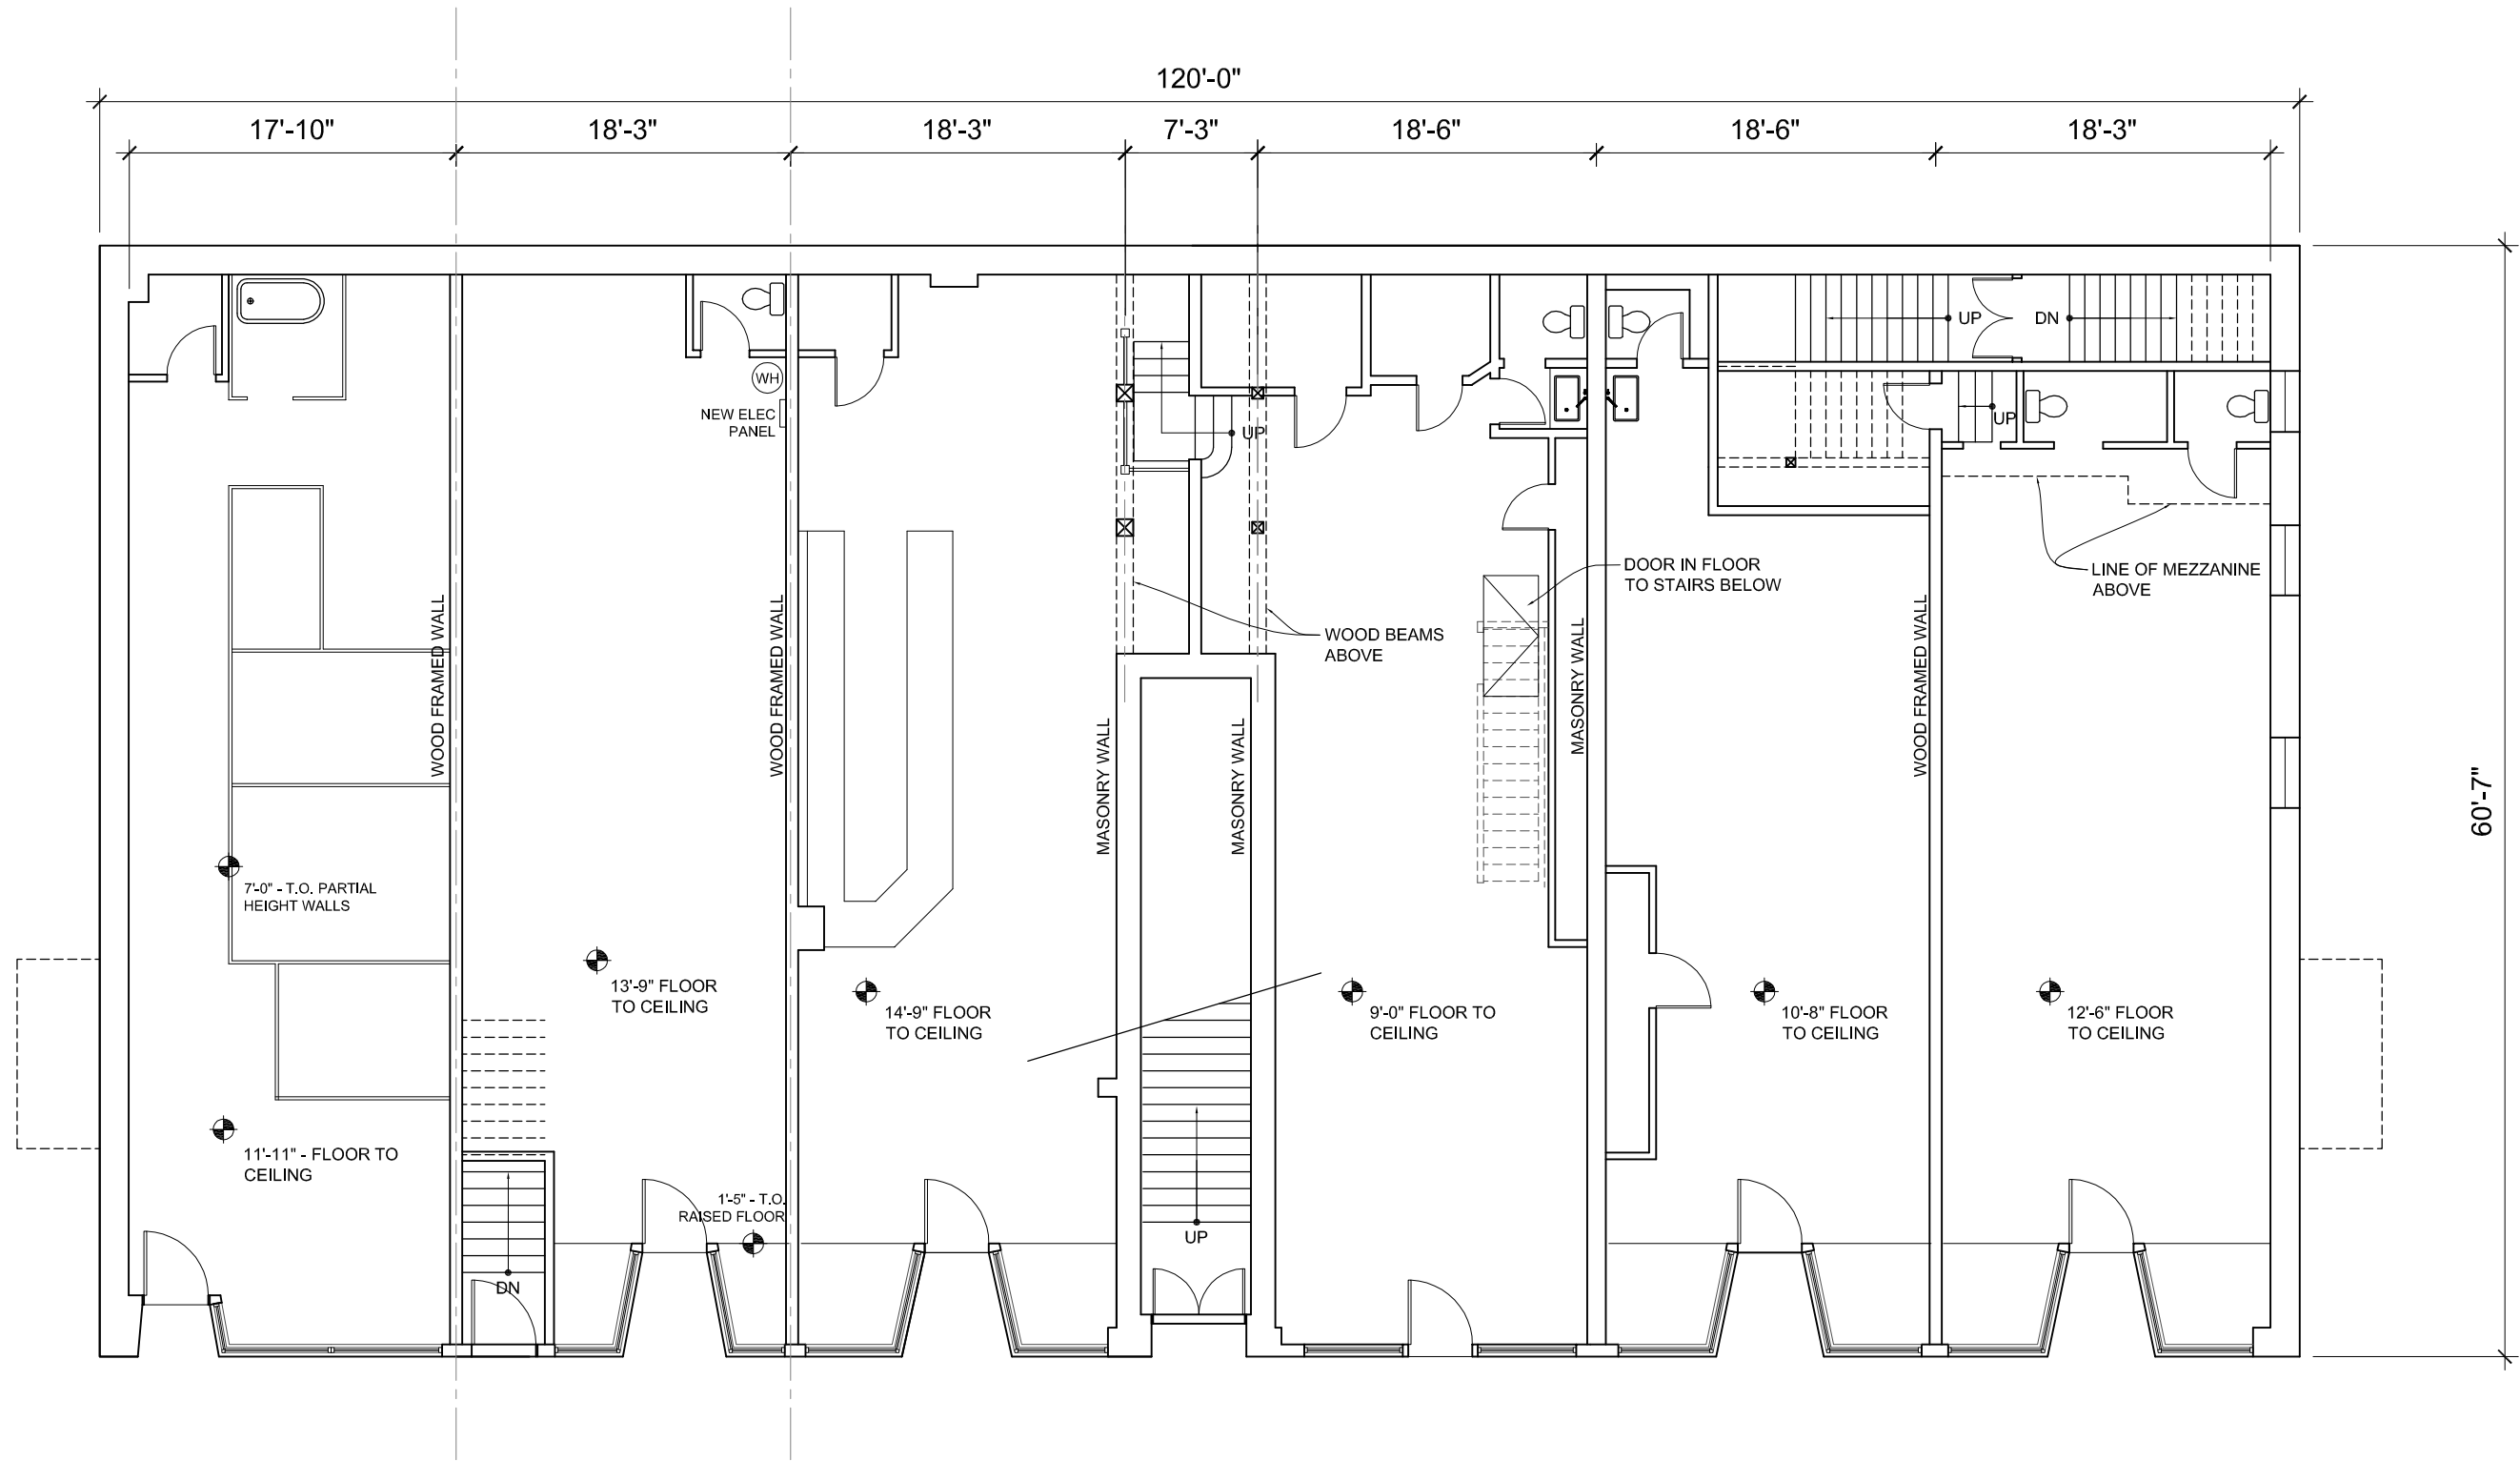

1st floor


SCALE: 1" = 10'-0"

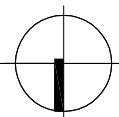

Panama Hotel


As-Built Drawings
April 7th, 2014

Drawn by:
Brian Baker
 414 13th Ave E PH1
 Seattle, WA 98102
 206.931.6452
 bmbaker.arch@gmail.com

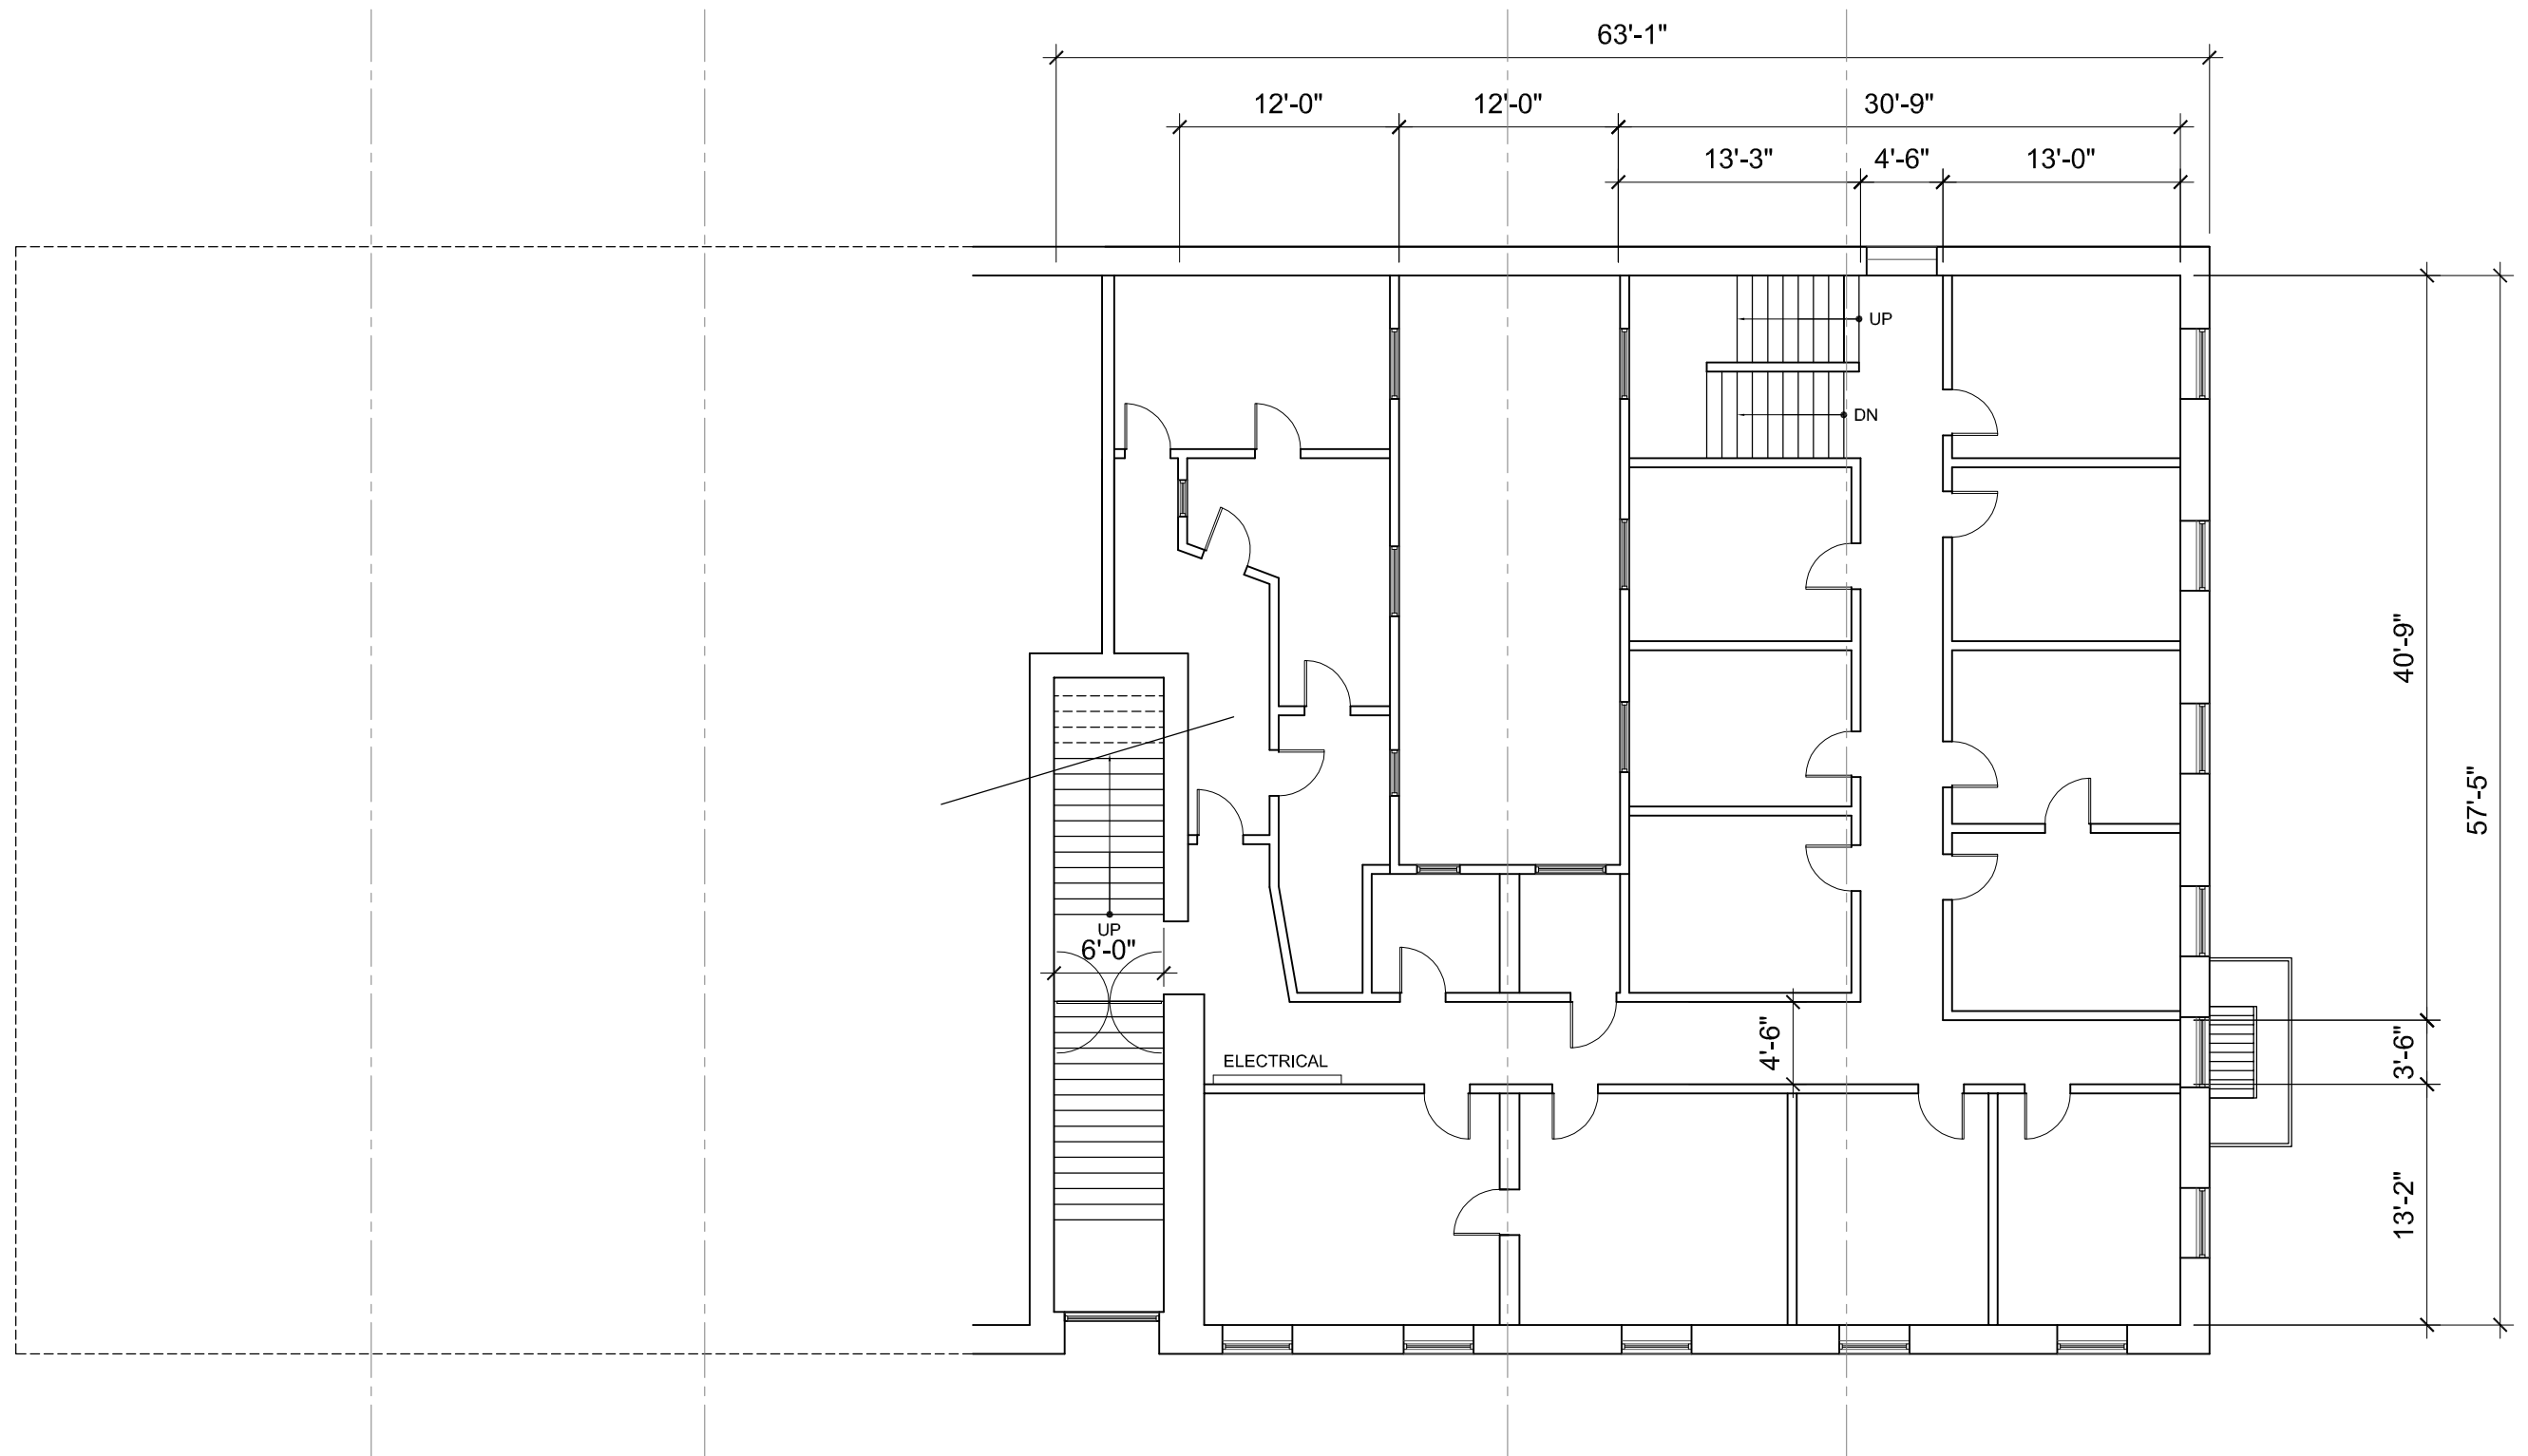

2nd floor


SCALE: 1" = 10'-0"

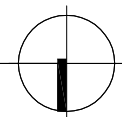

Panama Hotel


As-Built Drawings
April 7th, 2014

Drawn by:
Brian Baker
 414 13th Ave E PH1
 Seattle, WA 98102
 206.931.6452
 bmbaker.arch@gmail.com

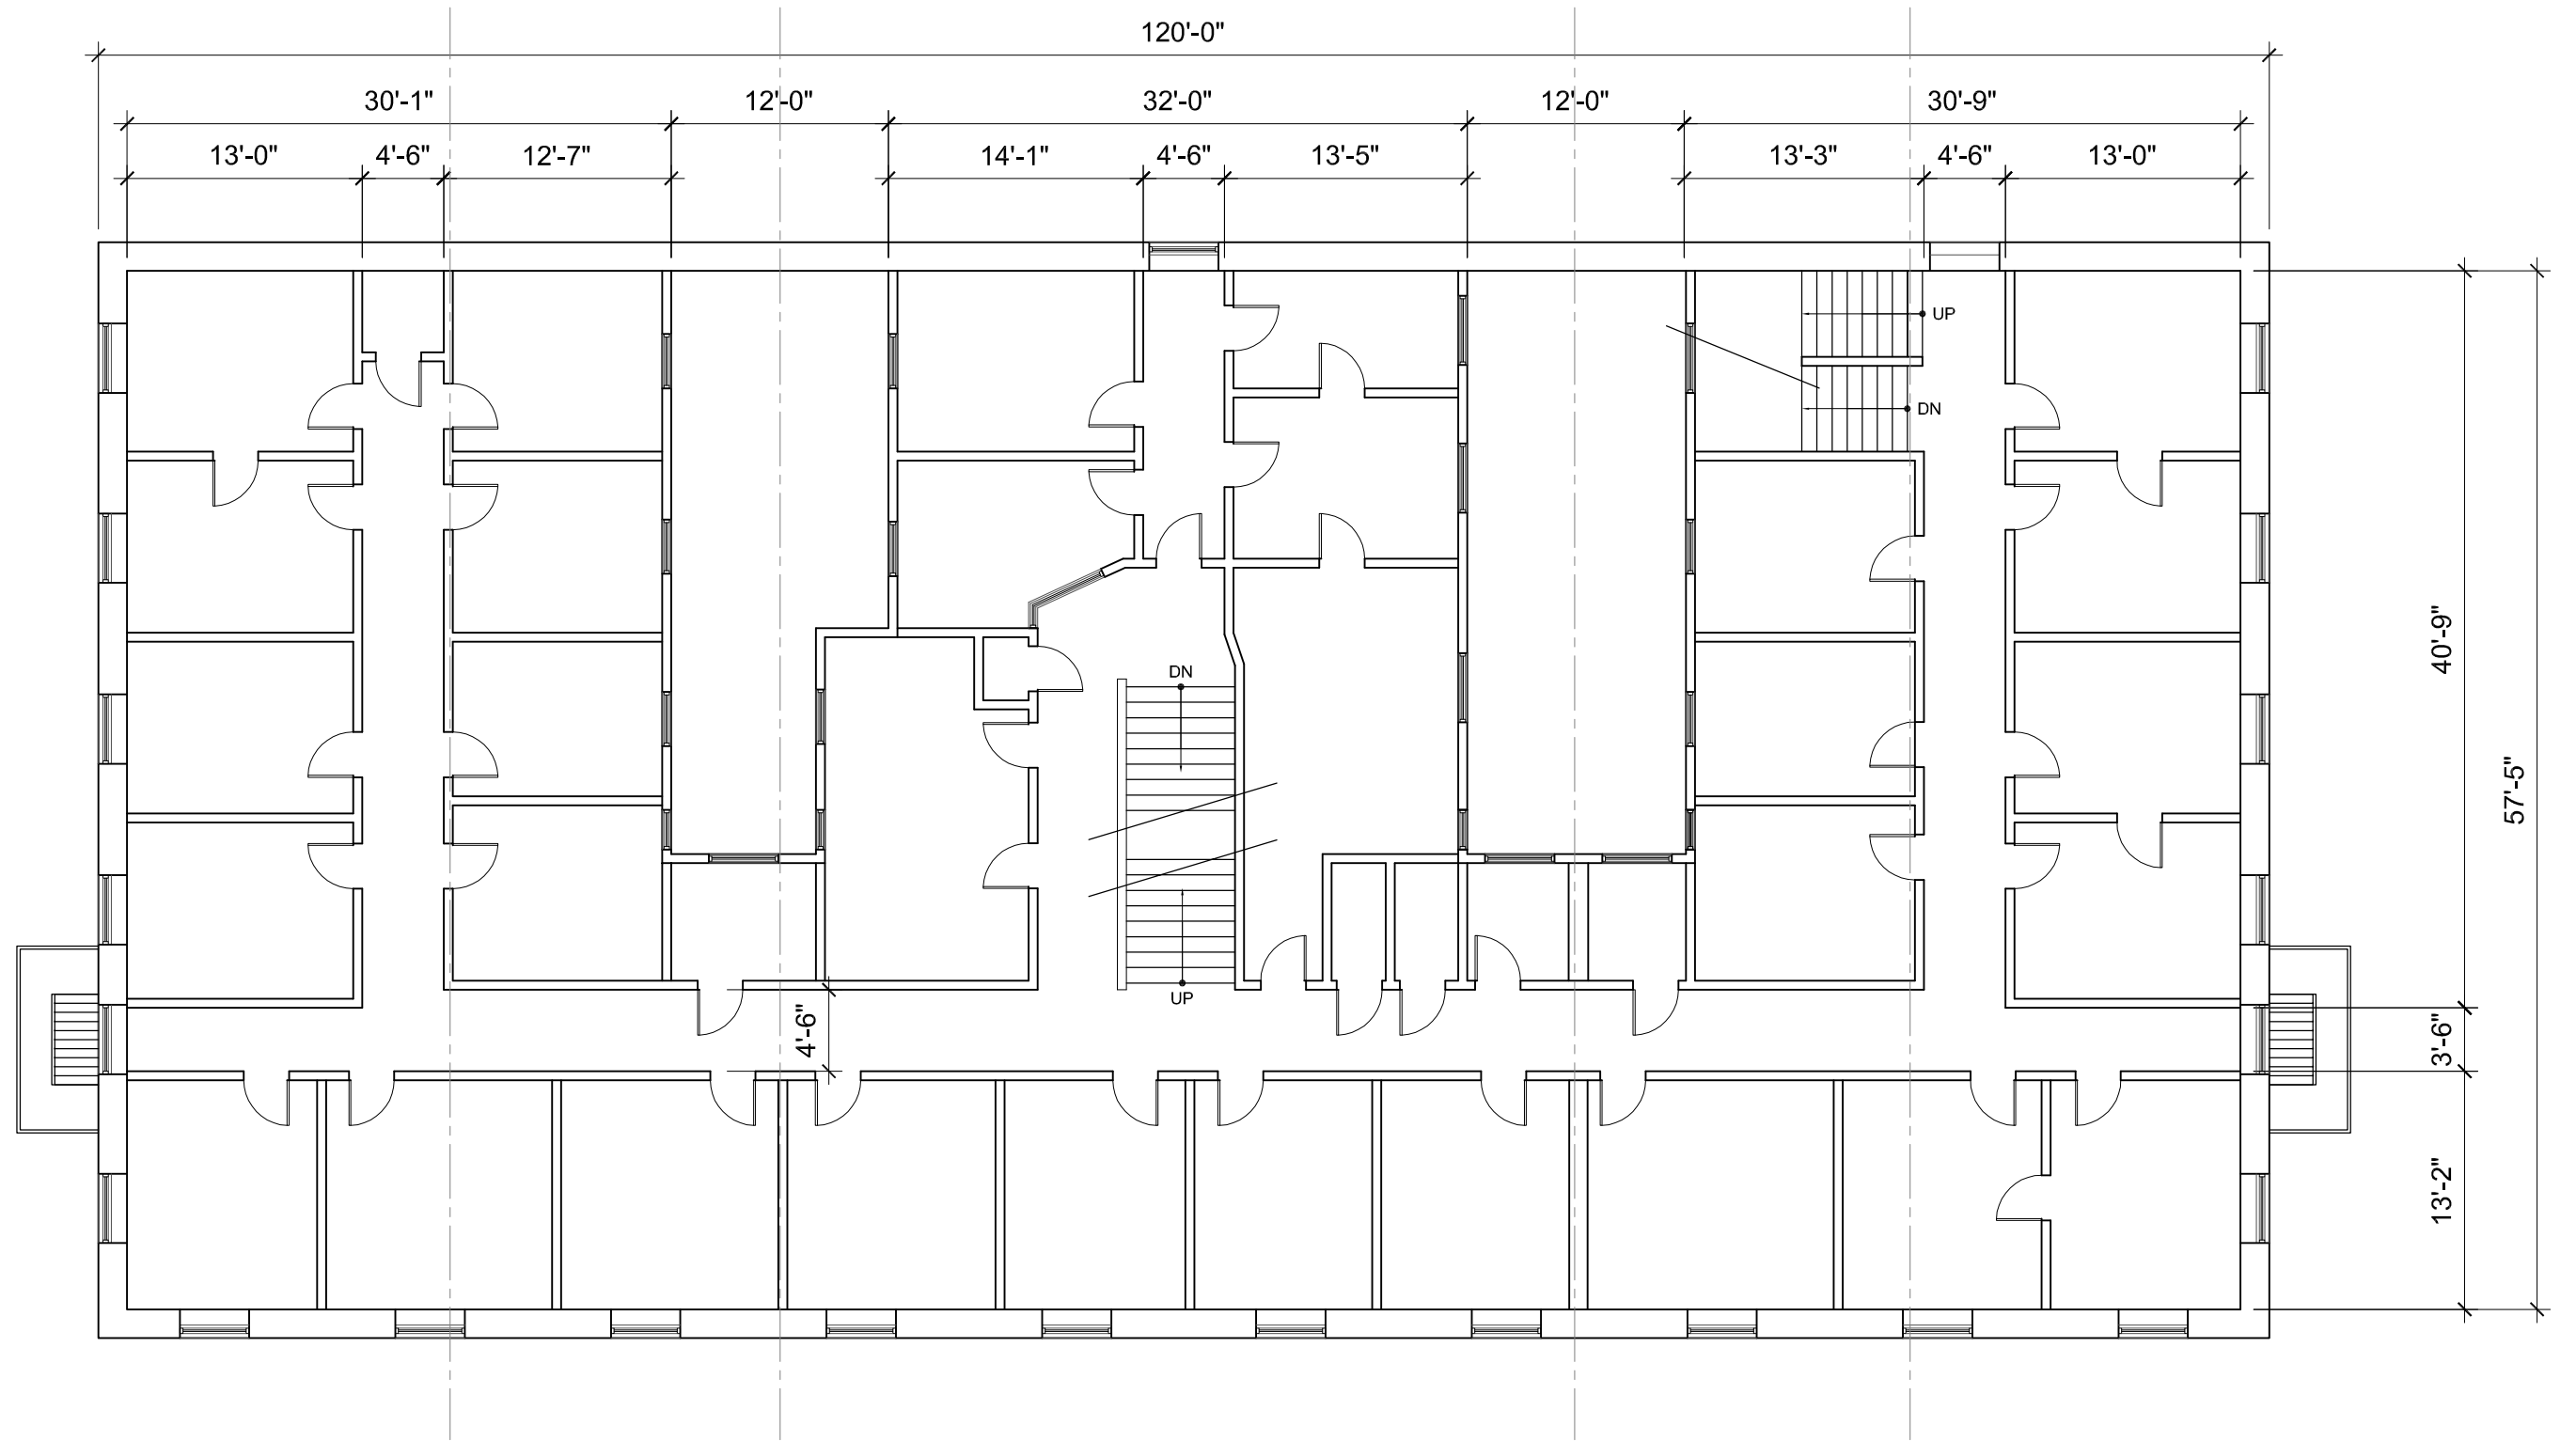

3rd floor


SCALE: 1" = 10'-0"

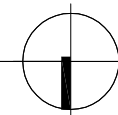

Panama Hotel


As-Built Drawings
April 7th, 2014

Drawn by:
Brian Baker
414 13th Ave E PH1
Seattle, WA 98102
206.931.6452
bmbaker.arch@gmail.com

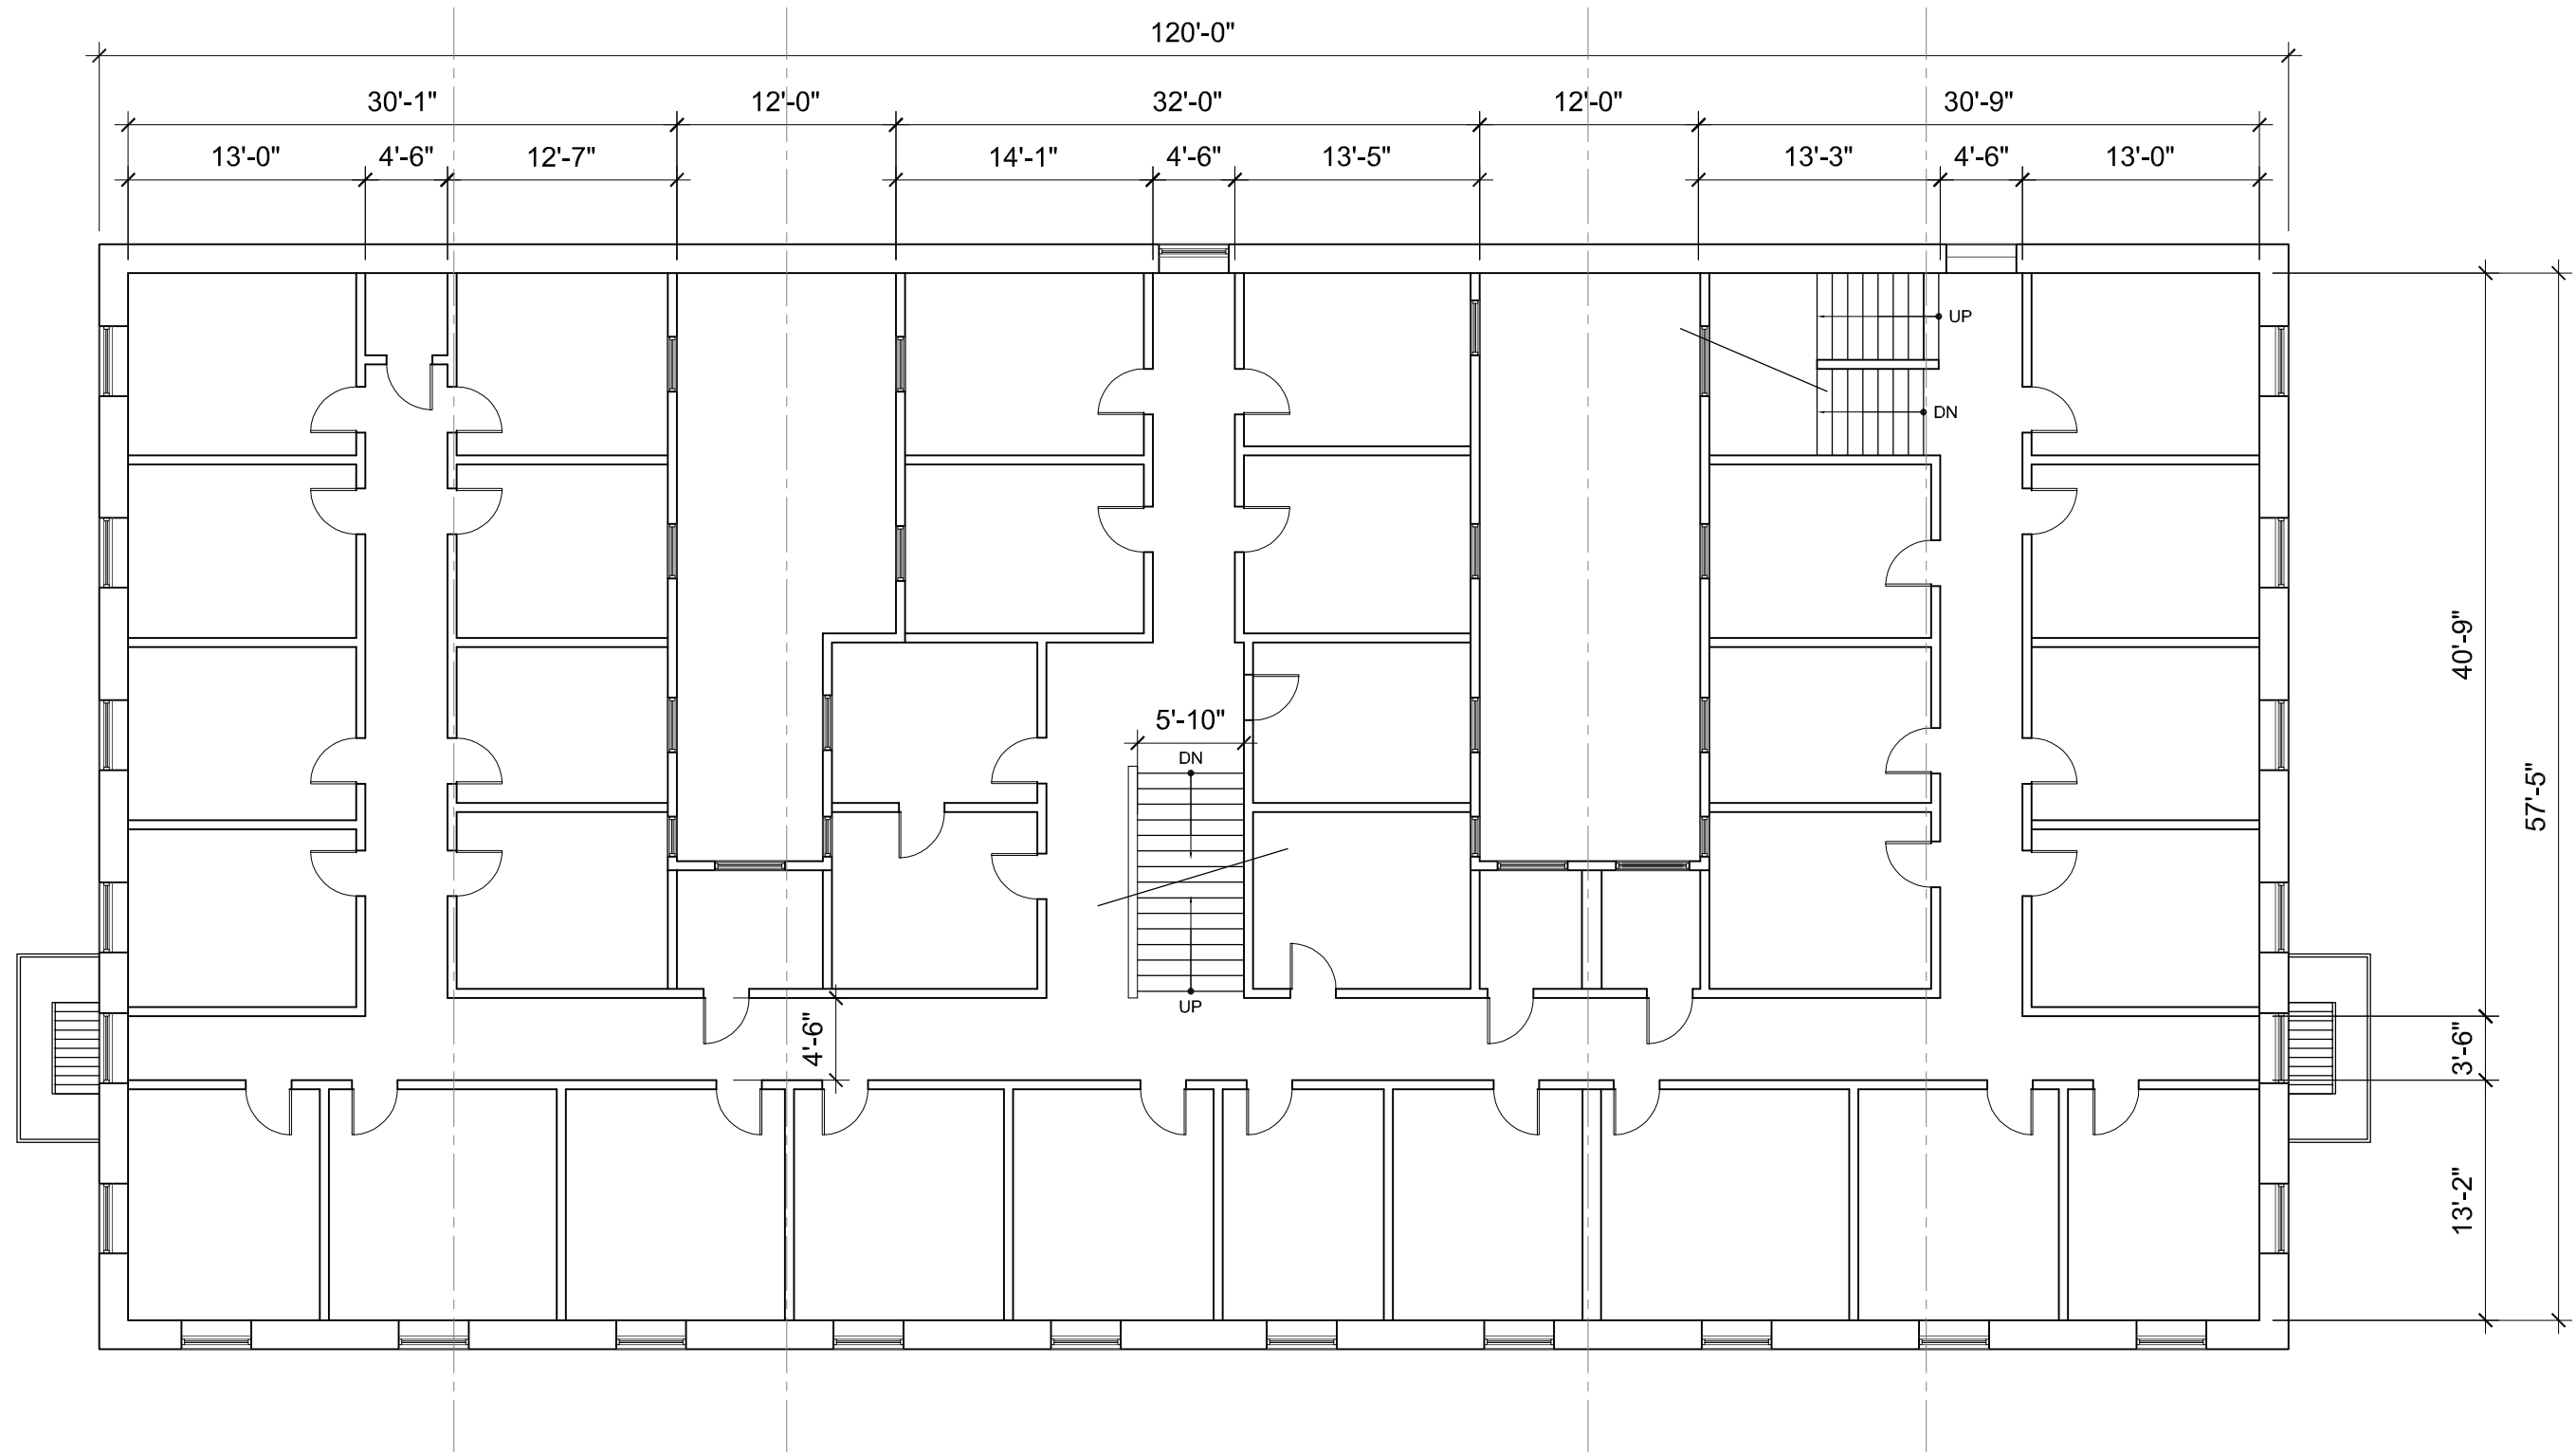

4th floor

SCALE: 1" = 10'-0"

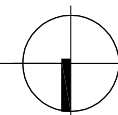

Panama Hotel

As-Built Drawings
April 7th, 2014


Drawn by:

Brian Baker

414 13th Ave E PH1
Seattle, WA 98102


206.931.6452

bmbaker.arch@gmail.com

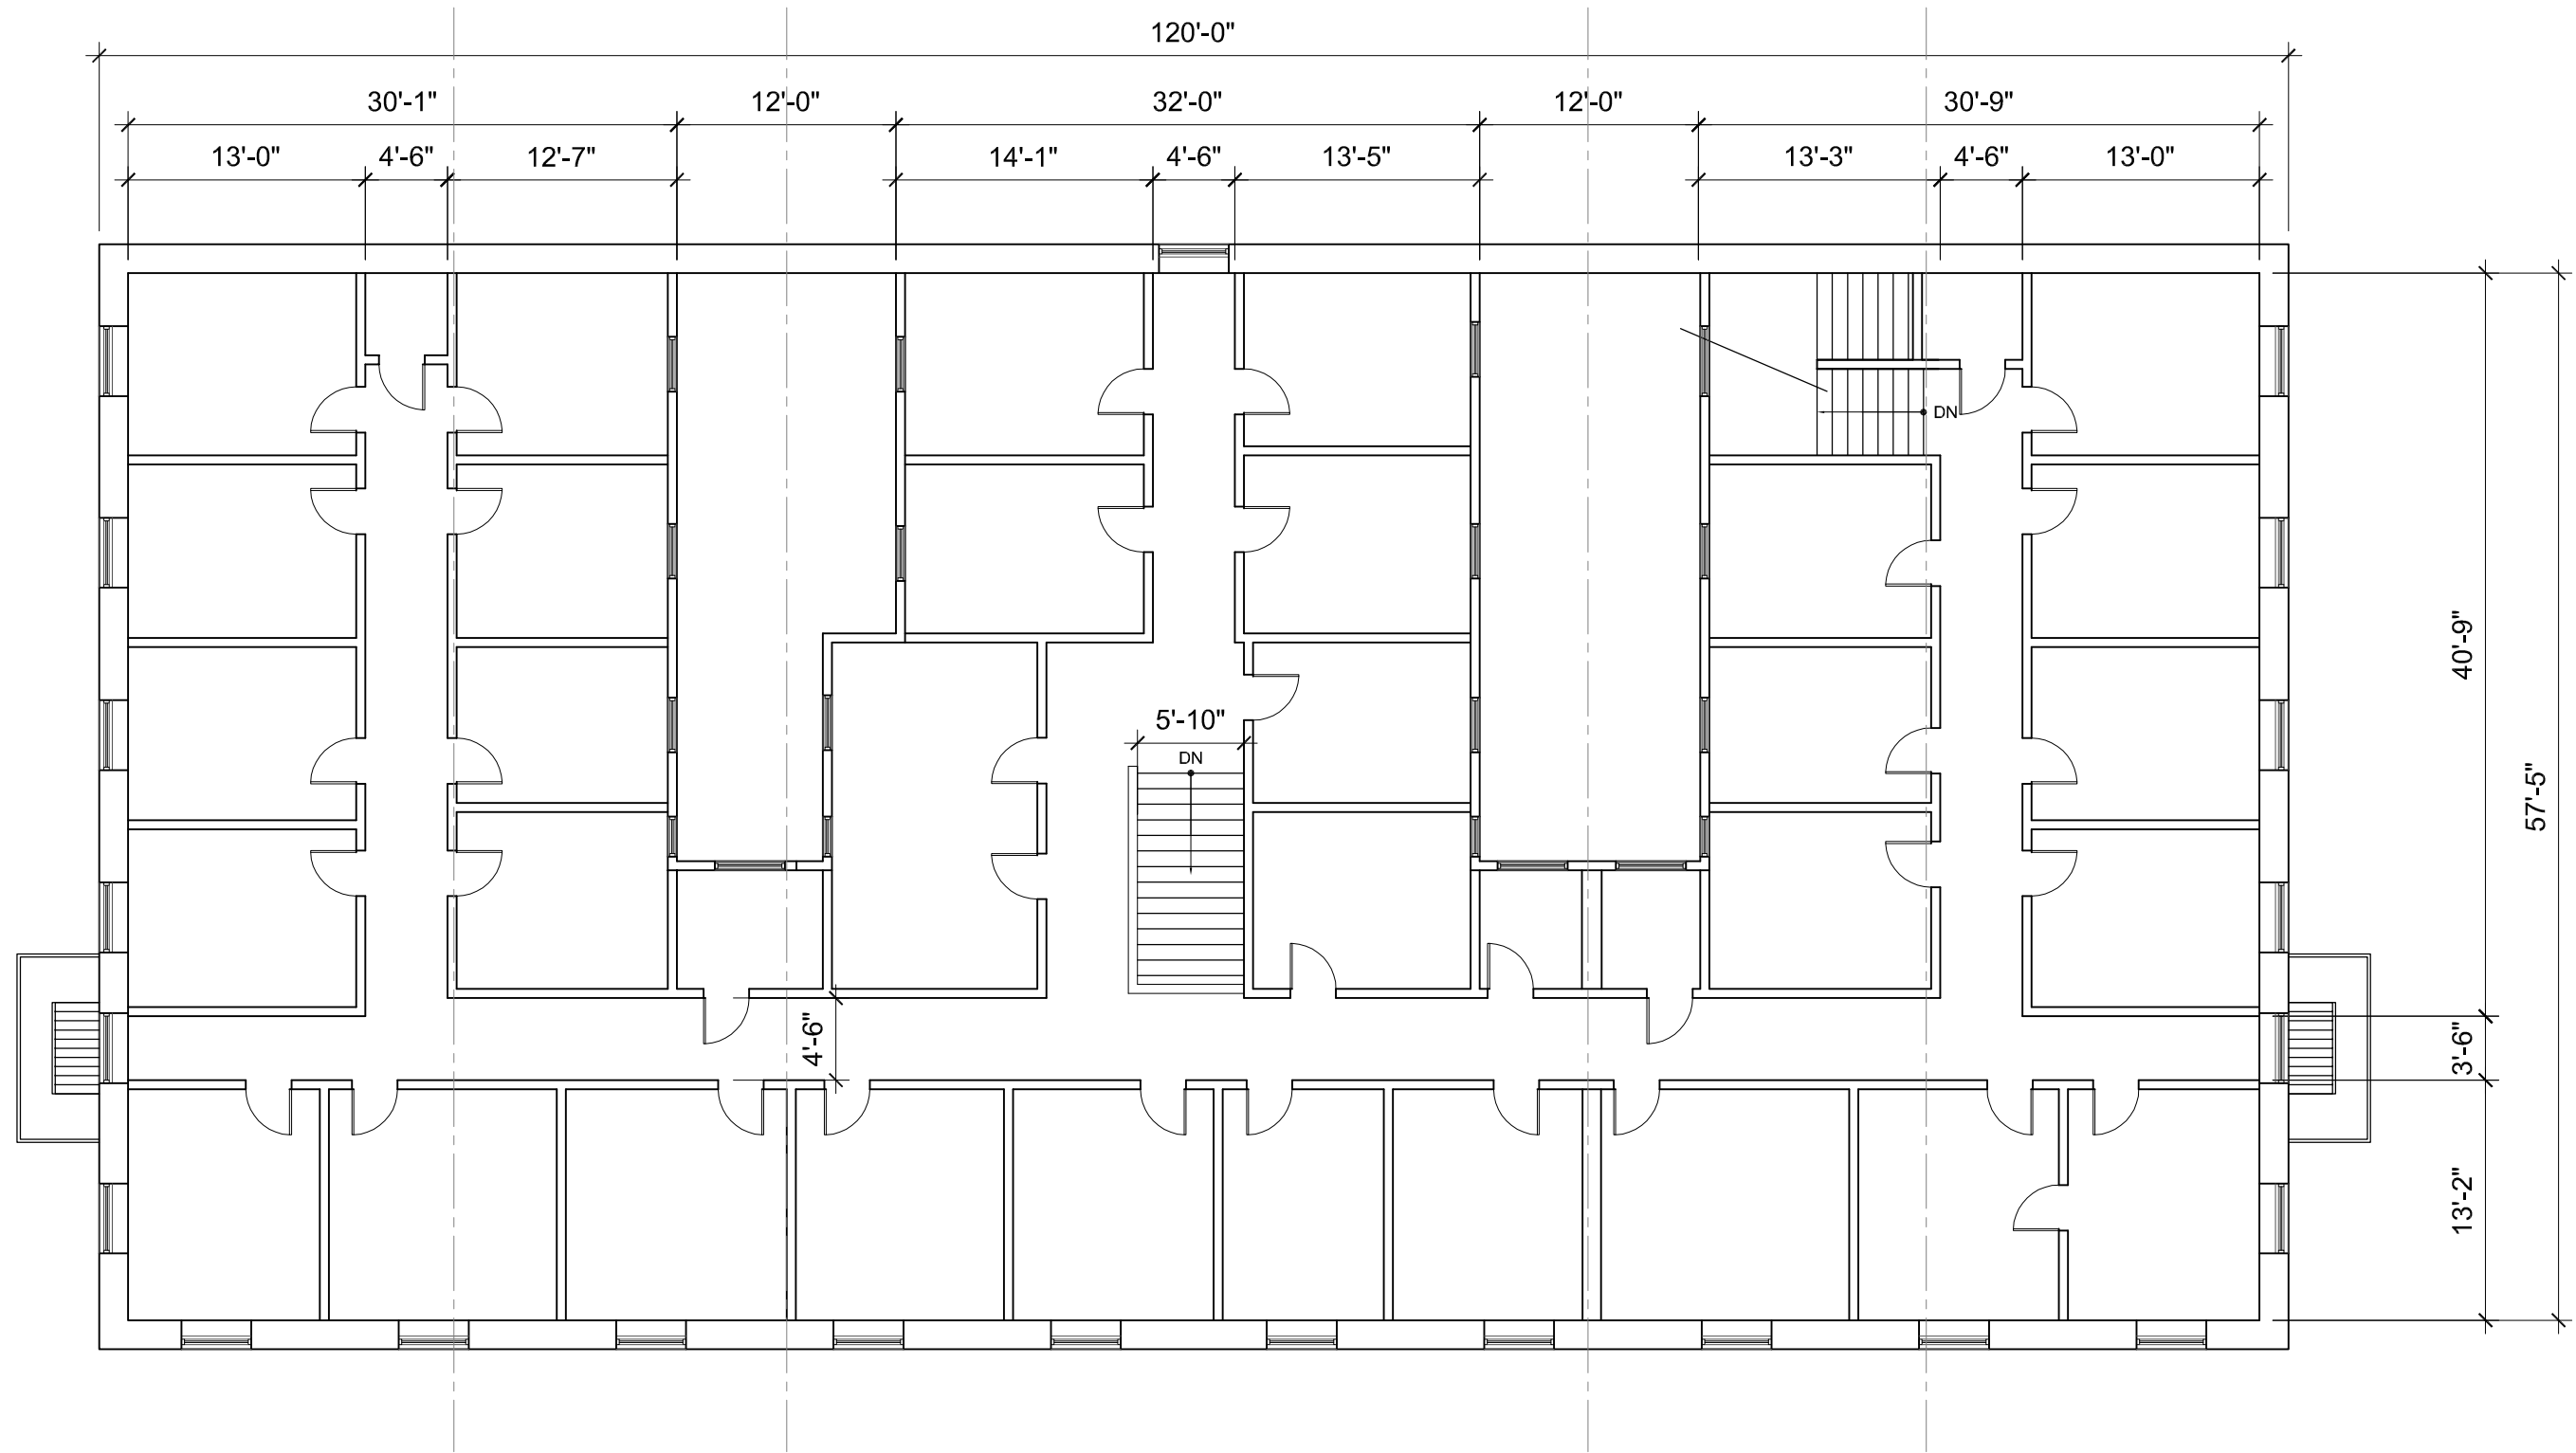

5th floor

SCALE: 1" = 10'-0"

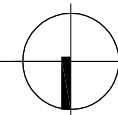

Panama Hotel

As-Built Drawings
April 7th, 2014

Drawn by:

Brian Baker

414 13th Ave E PH1
Seattle, WA 98102

206.931.6452

bmbaker.arch@gmail.com




North Elevation

SCALE: 1" = 10'-0"

Panama Hotel
As-Built Drawings
April 7th, 2014

Drawn by:
Brian Baker
414 13th Ave E PH1
Seattle, WA 98102
206.931.6452
bmbaker.arch@gmail.com

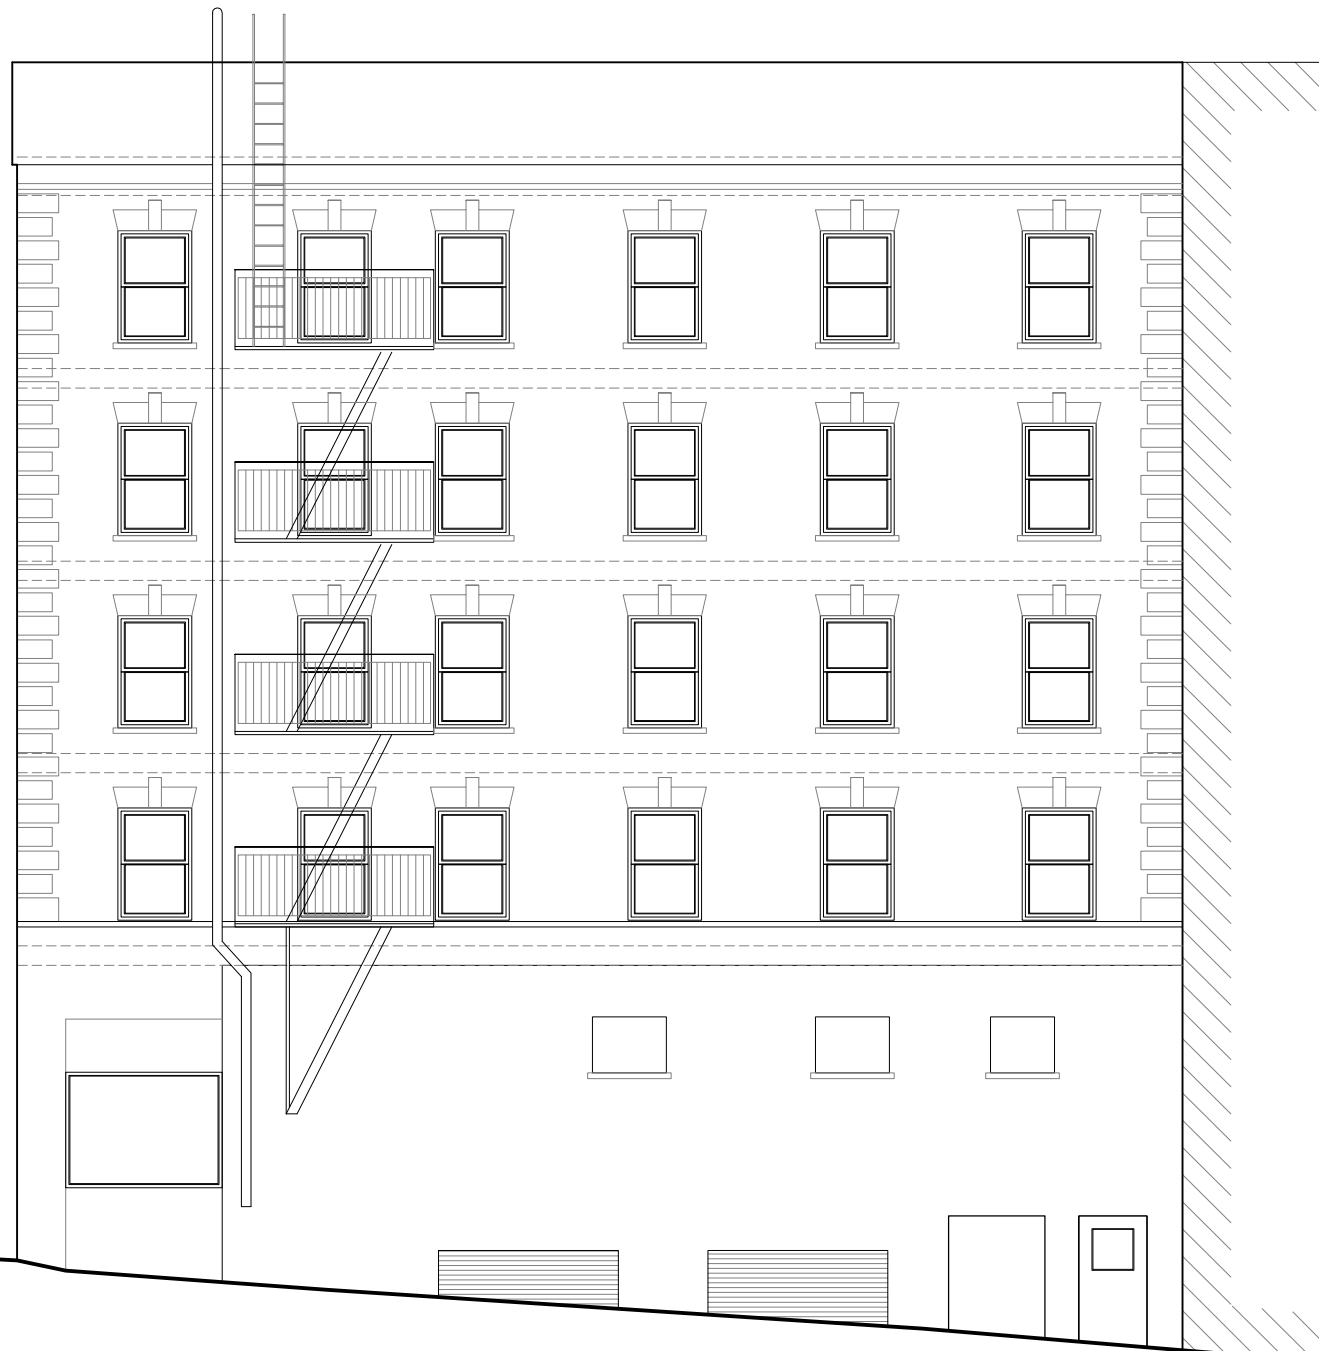


West Elevation

SCALE: 1" = 10'-0"

Panama Hotel

As-Built Drawings
April 7th, 2014

Drawn by:
Brian Baker
414 13th Ave E PH1
Seattle, WA 98102
206.931.6452
bmbaker.arch@gmail.com

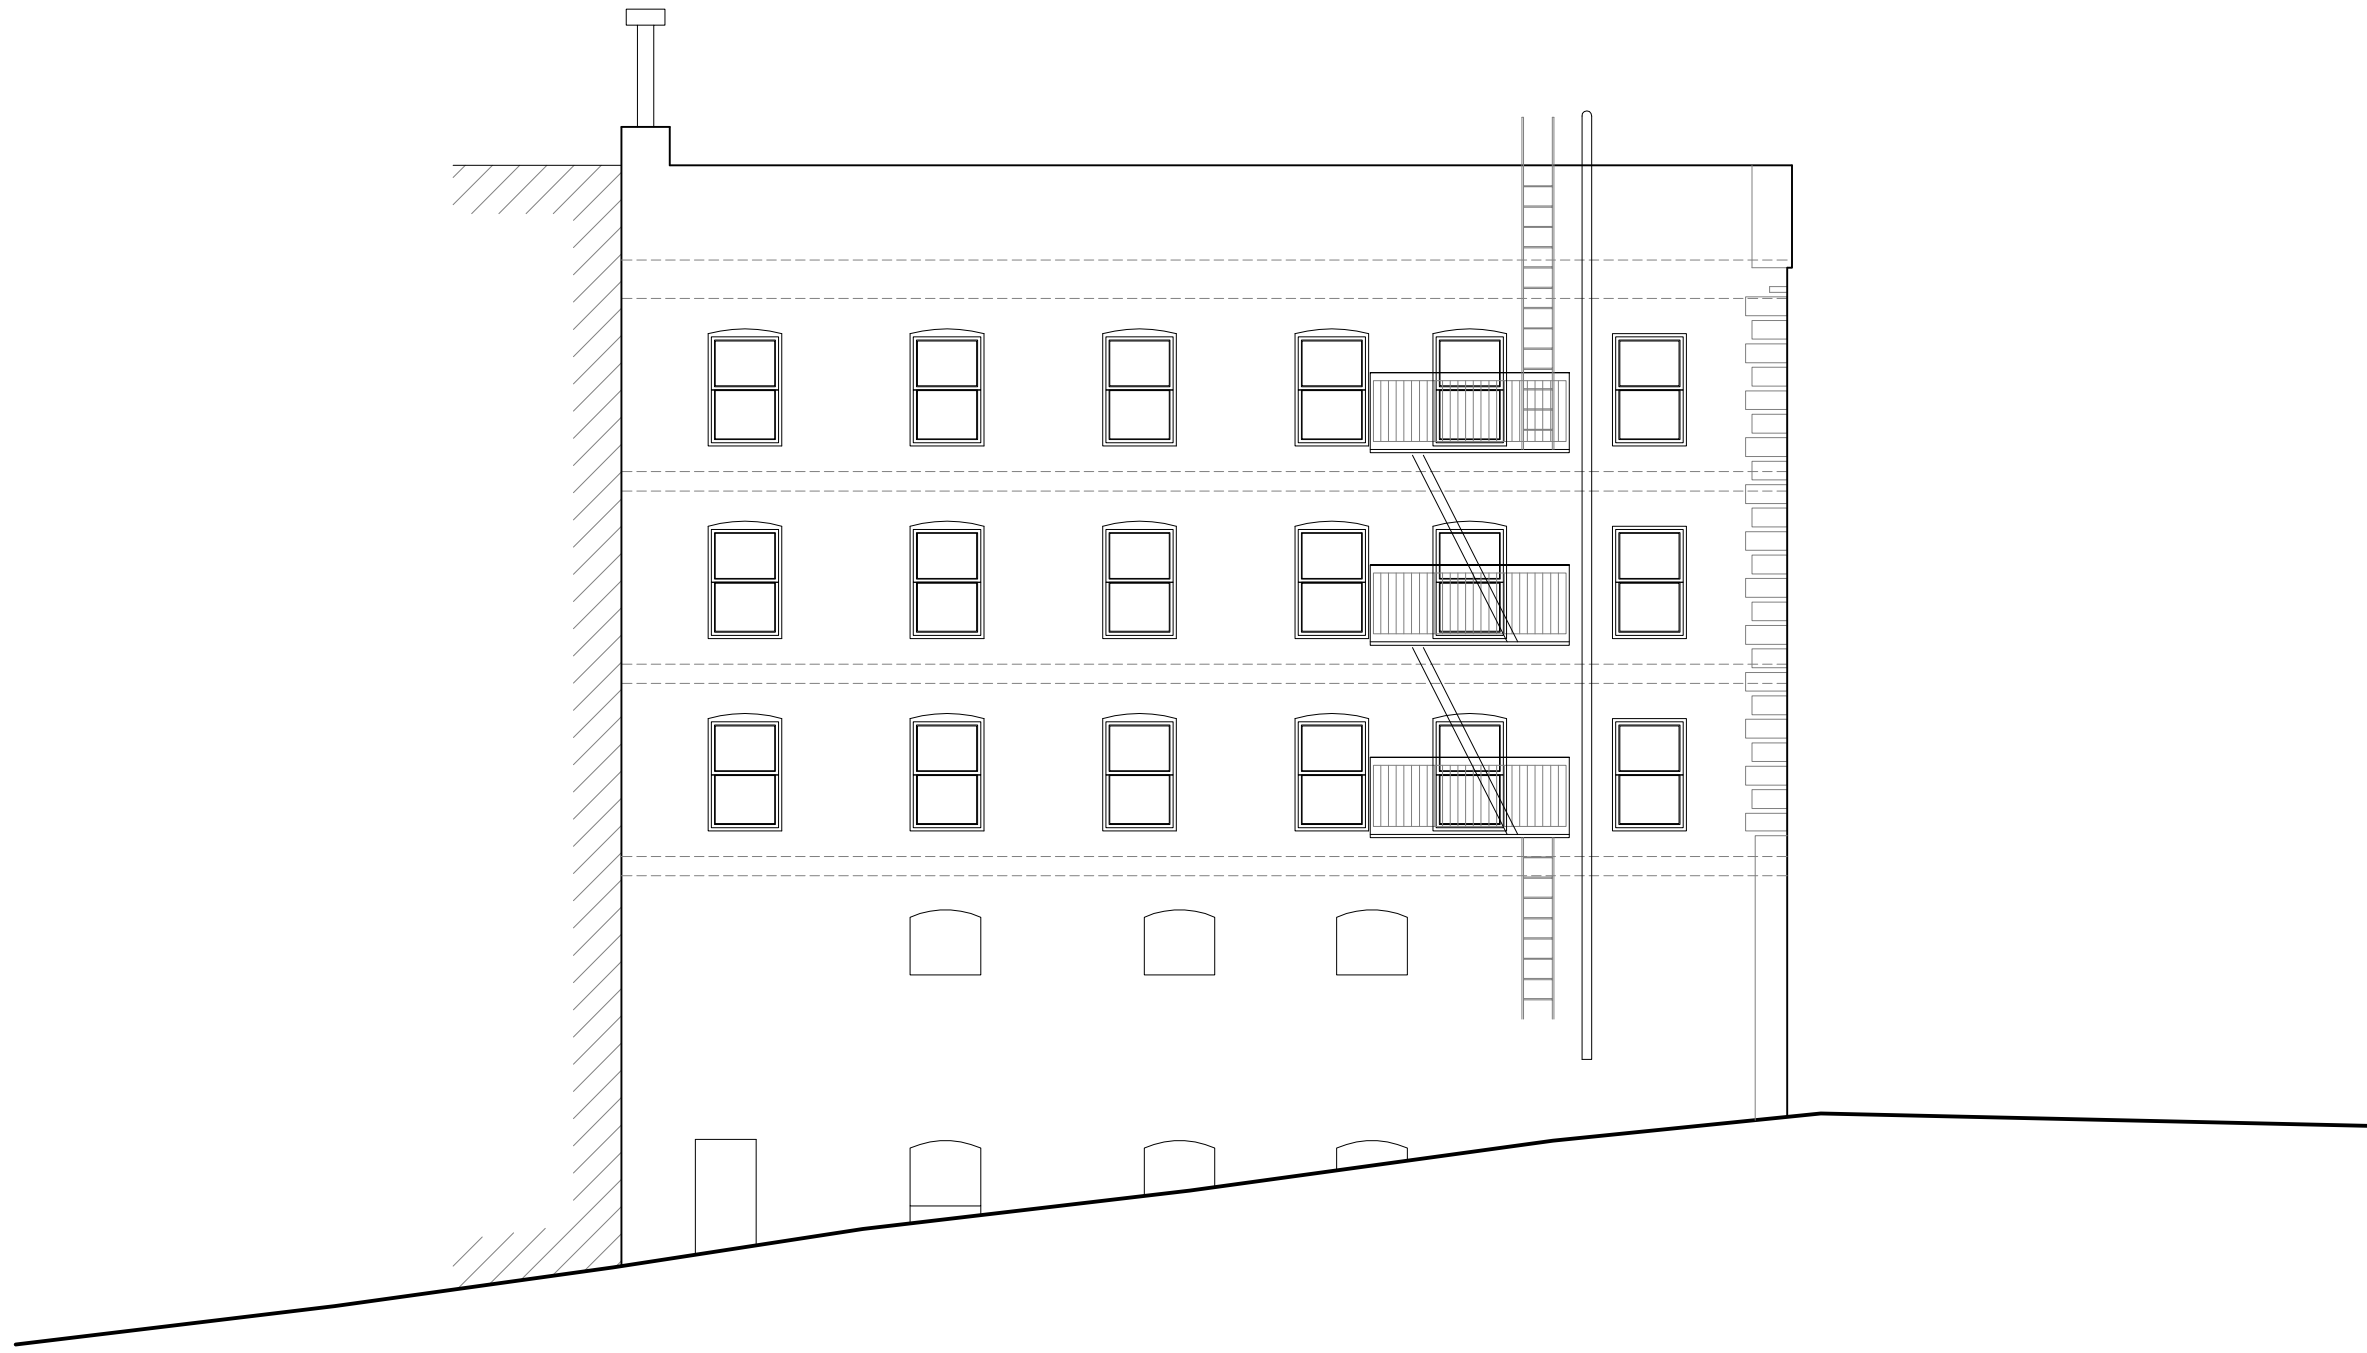

East Elevation

SCALE: 1" = 10'-0"

Panama Hotel

As-Built Drawings
April 7th, 2014

Drawn by:
Brian Baker
414 13th Ave E PH1
Seattle, WA 98102
206.931.6452
bmbaker.arch@gmail.com